

CENDEK RAILINGS LTD.

TEST REPORT

SCOPE OF WORK

REPORT OF 8 FT. CENTURY ROUND WELDED PANEL – WB MOUNT (3.875 IN. PICKET SPACING) AND 8 FT. CENTURY ROUND WELDED PANEL – WB MOUNT (3.5 IN. PICKET SPACING) RAILING SYSTEMS TESTED IN ACCORDANCE WITH ASTM E935-E13E¹, *STANDARD TEST METHODS FOR PERFORMANCE OF PERMANENT METAL RAILING SYSTEMS AND RAILS FOR BUILDINGS*

REPORT NUMBER

104715588COQ-002D

TEST DATES

07/16/21 – 07/23/21

ISSUE DATE

08/16/21


PAGES

26

DOCUMENT CONTROL NUMBER

GFT-OP-10c (09/29/20)

© 2020 INTERTEK

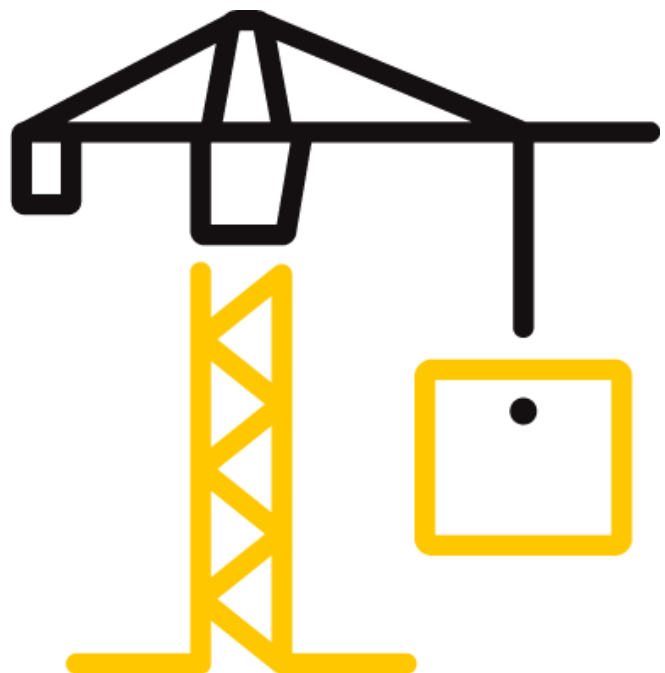

TEST REPORT FOR CENDEK RAILINGS LTD.

Report No.: 104715588COQ-002D

Date: 08/16/21

REPORT ISSUED TO CENDEK RAILINGS LTD.



9685 Agur St.
Summerland, BC, V0H 1Z2
Canada

SECTION 1 SCOPE

Intertek Building & Construction (B&C) was contracted by Cendek Railings Ltd., 9685 Agur St., Summerland, BC, V0H 1Z2, Canada to perform testing on the 8 ft. Century Round Welded Panel – WB Mount (3.875 in. Picket Spacing) and 8 ft. Century Round Welded Panel – WB mount (3.5 in. Picket Spacing) Railing Systems in accordance with ASTM E935-13e¹, *Standard Test Methods for Performance of Permanent Metal Railing Systems and Rails for Buildings*. The scope of the testing as requested by Cendek Railings Ltd., was to assess the ability of the guard systems to resist the load requirements of Section 1607.8.1 of the 2018 IBC and R301.5 of the 2018 IRC. Results obtained are tested values and were secured by using the designated test method(s). Testing was conducted at the Intertek test facility in Coquitlam, BC, Canada between July 16, 2021 to July 23, 2021.

This report does not constitute certification of this product nor an opinion or endorsement by this laboratory.

For INTERTEK B&C:

COMPLETED BY:	Chris Chang	REVIEWED BY:	Baldeep Sandhu
TITLE:	Sr. Tech – Building & Construction	TITLE:	Manager – Building & Construction
SIGNATURE:		SIGNATURE:	
DATE:	08/16/21	DATE:	08/16/21

This report is for the exclusive use of Intertek's Client and is provided pursuant to the agreement between Intertek and its Client. Intertek's responsibility and liability are limited to the terms and conditions of the agreement. Intertek assumes no liability to any party, other than to the Client in accordance with the agreement, for any loss, expense or damage occasioned by the use of this report. Only the Client is authorized to permit copying or distribution of this report and then only in its entirety. Any use of the Intertek name or one of its marks for the sale or advertisement of the tested material, product or service must first be approved in writing by Intertek. The observations and test results in this report are relevant only to the sample(s) tested. This report by itself does not imply that the material, product, or service is or has ever been under an Intertek certification program.

TEST REPORT FOR CENDEK RAILINGS LTD.

Report No.: 104715588COQ-002D

Date: 08/16/21

SECTION 2

SUMMARY OF TEST RESULTS

SYSTEM DESCRIPTION	TEST	PASS/FAIL
8 ft. Century Round Welded Panel – WB Mount (3.875 in. Picket Spacing)	In-fill Load	Pass
	Uniform Load	Pass
	Horizontal – Mid-Span Concentrated Load	Pass
	Horizontal – Adjacent to Post Concentrated Load	Pass
8 ft. Century Round Welded Panel – WB Mount (3.5 in. Picket Spacing)	In-fill Load	Pass
	Uniform Load	Pass
	Horizontal – Mid-Span Concentrated Load	Pass
	Horizontal – Adjacent to Post Concentrated Load	Pass

Refer to Appendix B for photos of testing.

TEST REPORT FOR CENDEK RAILINGS LTD.

Report No.: 104715588COQ-002D

Date: 08/16/21

SECTION 3 TEST METHOD

The guard specimens were evaluated in accordance with the following:

ASTM E935-13e1, *Standard Test Methods for Performance of Permanent Metal Railing Systems and Rails for Buildings.*

The required test loads were based on the Specified Loads per the following Building Code articles with the Safety Factors applied as indicated in this report.

2018 International Building Code (IBC)

- Section 1607.8.1 *Handrails and Guards*

2018 International Residential Code (IRC)

- R301.5 *Live Load*

SECTION 4 MATERIAL SOURCE

The client submitted the railing systems to the Evaluation Center on July 9, 2021 (Coquitlam ID# VAN2107090927-001) and July 22, 2021 (Coquitlam ID# VAN2107220908-001). The samples were received in good condition and were suitable for testing unless noted otherwise. The samples were not independently selected for testing.

SECTION 5 EQUIPMENT

Calibration of test equipment was performed by Intertek B&C in accordance with ISO 17025 requirements.

ASSET #	DESCRIPTION	MODEL	CAL DUE DATE
P60692	Artech 5k lb S-Type Load Cell	20210-5k	10/22/21
P60554	T&D Temperature and Humidity Indicator	TR-72Ui	09/10/21
P60444	Extech Stopwatch	365515	03/05/22
52650	Mitutoyo 8 in. Digital Caliper	CD-8	06/08/22
P60494	Stanley Tape Measure	FatMax	09/08/21

TEST REPORT FOR CENDEK RAILINGS LTD.

Report No.: 104715588COQ-002D

Date: 08/16/21

SECTION 6

LIST OF OFFICIAL OBSERVERS

NAME	COMPANY
Kevin Penner	Intertek B&C
Chris Chang	Intertek B&C

Note: The above observer(s) witnessed part of the test program.

TEST REPORT FOR CENDEK RAILINGS LTD.

Report No.: 104715588COQ-002D

Date: 08/16/21

SECTION 7**TESTING PROCEDURE**

The evaluation was conducted in accordance with the testing procedures of ASTM E935-13e¹, *Standard Test Methods for Performance of Permanent Metal Railing Systems and Rails for Buildings*. The test specimens were loaded at a rate to achieve the specified loads between 10 seconds and 5 minutes. The specified test loads were held for one minute before the load was released. Testing was conducted with reference to the specified load requirements of the following:

IN-FILL LOAD TEST

The in-fill load test was conducted in accordance with Section 1607.8.1.2 *Intermediate Rails* of the 2018 IBC and Table R301.5 *Minimum Uniformly Distributed Live Loads* of the 2018 IRC. Testing was conducted with reference to Section 4.5.1 *Loads on Handrail and Guardrail Systems* of ASCE/SEI 7-10, *Minimum Design Loads for Buildings and Other Structures* with a safety factor of 2.5. A load of 125 lbs was applied using a 1 square foot block normal to the in-fill. After release of the load, the system was evaluated for failure, any evidence of disengagements of any component and/or visible cracking from any component.

UNIFORM LOAD TEST

The uniform load test was conducted in accordance with Section 1607.8.1 *Handrails and Guards* of the 2018 IBC and Table R301.5 *Minimum Uniformly Distributed Live Loads* of the 2018 IRC. Testing was conducted with reference to Section 4.5.1 *Loads on Handrail and Guardrail Systems* of ASCE/SEI 7-10, *Minimum Design Loads for Buildings and Other Structures* with a safety factor of 2.5. The top rail of the guardrail system was subjected to a uniform load of 125 plf applied horizontally. The load was applied using quarter point loads. After release of the load, the system was evaluated for failure, any evidence of disengagements of any component and visible cracks in any component.

CONCENTRATED LOAD TEST

The concentrated load tests were conducted in accordance with Section 1607.8.1.1 *Concentrated Load* of the 2018 IBC and Table R301.5 *Minimum Uniformly Distributed Live Loads* of the 2018 IRC. Testing was conducted with reference to Section 4.5.1 *Loads on Handrail and Guardrail Systems* of ASCE/SEI 7-10, *Minimum Design Loads for Buildings and Other Structures* with a safety factor of 2.5. The top rail of the guardrail system was subjected to two (2) separate horizontal tests where a concentrated load of 500 lbs was applied:

- horizontally at the mid-span of the top rail, and
- horizontally at the top rail adjacent to the post connection to verify the connection capacity.

As there were no posts in the railing system, the concentrated load at the top of post was not evaluated.

TEST REPORT FOR CENDEK RAILINGS LTD.

Report No.: 104715588COQ-002D

Date: 08/16/21

After release of the load, the system was evaluated for failure, any evidence of disengagements of any component and/or visible cracking from any component.

TEST REPORT FOR CENDEK RAILINGS LTD.

Report No.: 104715588COQ-002D

Date: 08/16/21

SECTION 8

TEST SPECIMEN DESCRIPTION

The samples were identified as the following:

TABLE 1. RAILING CONFIGURATION							
PART NAME	PART NUMBER	QTY	PART DIMENSIONS				REPORTED MATERIAL
			LENGTH	WIDTH	HEIGHT	NOMINAL THICKNESS	
8 FT. CENTURY ROUND WELDED PANEL – WB MOUNT (3.5 IN. PICKET SPACING)							
Top Rail Wall Bracket	4104-WAL-10100	2	3.5 in.	2.5 in.	1.375 in.	0.125 in.	Aluminum
Bottom Rail Wall Bracket	4100-WAL-10100	2	2.38 in.	1.75 in.	1.03 in.	0.125 in.	Aluminum
Top Rail	N/A	1	96.0 in.	2.36 in.	1.89 in.	0.08 in.	Aluminum
Bottom Rail	N/A	1	96.0 in.	1.32 in.	1.41 in.	0.07 in.	Aluminum
Support Leg	4600-LEG-60100	2	2.50 in.	1.00 in.	2.92 in.	0.125 in.	Aluminum
Infill - Picket	N/A	23	0.625 in.	0.625 in.	39.0 in.	0.050 in.	Aluminum
8 FT. CENTURY ROUND WELDED PANEL – WB MOUNT (3.875 IN. PICKET SPACING)							
Top Rail Wall Bracket	4104-WAL-10100	2	3.5 in.	2.5 in.	1.375 in.	0.125 in.	Aluminum
Bottom Rail Wall Bracket	4100-WAL-10100	2	2.38 in.	1.75 in.	1.03 in.	0.125 in.	Aluminum
Top Rail	N/A	1	96.0 in.	2.36 in.	1.89 in.	0.08 in.	Aluminum
Bottom Rail	N/A	1	96.0 in.	1.32 in.	1.41 in.	0.07 in.	Aluminum
Support Leg	4600-LEG-60100	2	2.50 in.	1.00 in.	2.92 in.	0.125 in.	Aluminum
Infill - Picket	N/A	21	0.625 in.	0.625 in.	39.0 in.	0.050 in.	Aluminum

Note 1: Each railing had two (2) support legs positioned under the bottom rail spaced 32.75 in. from each end and were set on a steel test frame. For detailed drawings of the test samples and components, refer to Appendix C.

Note 2: As the railing systems had no posts, the assemblies were attached to a wood support through wall brackets. Per the client’s request, the guard assemblies were attached using supplied #12 x 2 in. long Pan Head Robertson steel sheet metal screws (0.416 in. head diameter x 0.158 in. shank diameter). The wood support was constructed from 2 layers of nominal 2 in. x 12 in. SPF lumber.

TEST REPORT FOR CENDEK RAILINGS LTD.

Report No.: 104715588COQ-002D

Date: 08/16/21

SECTION 9

TEST RESULTS

A full set of test results is included in Appendix A.

SECTION 10

CONCLUSION

Intertek Testing Services NA Ltd. (Intertek) has conducted testing for Cendek Railings Ltd. on the 8 ft. Century Round Welded Panel – WB Mount (3.875 in. Picket Spacing) and 8 ft. Century Round Welded Panel – WB mount (3.5 in. Picket Spacing) railing systems per ASTM E935-13e1, *Standard Test Methods for Performance of Permanent Metal Railing Systems and Rails for Buildings*. The scope of the testing as requested by Cendek Railings Ltd. was to assess the ability of the guard systems to resist the loads as prescribed in the following building code articles:

2018 International Building Code (IBC)

- Section 1607.8.1 *Handrails and Guards*

2018 International Residential Code (IRC)

- R301.5 *Live Load*

The Cendek Railings Ltd. 8 ft. Century Round Welded Panel – WB Mount (3.875 in. Picket Spacing) and 8 ft. Century Round Welded Panel – WB mount (3.5 in. Picket Spacing) railing systems identified and evaluated in this report have met the load requirements of the above criteria. Overall compliance with the Building Codes must be evaluated and approved by the Engineer of Record and Authority Having Jurisdiction.

The conclusions of this test may not be used as part of the requirements for Intertek product certification. Authority to Mark must be issued for a product to become certified.



Total Quality. Assured.

1500 Brigantine Drive
Coquitlam, BC, V3K 7C1

Telephone: 604-520-3321
Facsimile: 604-524-9186
www.intertek.com

TEST REPORT FOR CENDEK RAILINGS LTD.

Report No.: 104715588COQ-002D

Date: 08/16/21

SECTION 11

APPENDIX A – TEST DATA (3 PAGES)

Company	Cendek Railings Ltd.	Technician(s)	Kevin Penner
Project No.	G104715588	Reviewer	Baldeep Sandhu
Models	8 ft. Century Round Welded - 3.5 in. and 3.875 in. spacing	Start/End Date	July 16-23, 2021
Product Name	Same as above	Sample ID	VAN2107090927-001, VAN2107220908-001
Standard	2018 International Building Code (IBC), 2018 International Residential Code (IRC)		

Test Data Package

Table of Contents

Sheet	Page
Table of Contents (This Sheet)	1
Loads on Guards - 8 ft. Century Round Welded Panel - WB Mount (3.5 in. Picket Spacing)	2
Loads on Guards - 8 ft. Century Round Welded Panel - WB Mount (3.875 in. Picket Spacing)	3

Test: Loads on Guards
Date: 16-Jul-21
Client: Cendek Railings Ltd.
Product: **8 ft. Century Round Welded Panel - WB Mount (3.875 in. Picket Spacing)**
Post Spacing: 8.04 ft 2.45 m
Height of Guard: 42.1 in 1070 mm
Opening in Guard: 3.88 in 98 mm (between pickets)
 2.25 in 57 mm (under bottom rail)
Method: ASTM E935-13e1, *Standard Test Methods for Performance of Permanent Metal Railing Systems and Rails for Buildings*
 2018 International Building Code (IBC)
 2018 International Residential Code (IRC)
Safety Factor: 2.50
Equipment: Artech 5000 lbf Load Cell (Intertek ID# P60692, cal due October 22, 2021)
 T&D TR-72Ui Temperature and Humidity Logger (Intertek ID# P60554, cal due September 10, 2021)
 Stopwatch (Intertek ID# P60444, cal due March 5, 2022)
 Mitutoyo Digital Caliper (Intertek ID# 52650, cal due June 8, 2022)
Time/Temp/RH: 10:15AM / 22.9°C / 49.0%

Project: G104715588
Eng/Tech: Kevin Penner
 Baldeep Sandhu
Reviewer: Coquitlam, BC, Canada

Direction	Test	Design Load (Inward/Outward) (lbf)	Factored Load	Calculated Moment (lbf-ft)	Equivalent Quarter-Point Load (lbf)	Required Proof Load (lbf)	Pass/Fail
Outward	Individual Elements (over 12 in. x 12 in.) (most critical location)	50	125	-	-	125	Pass
	Midspan Horizontal Concentrated Load	200	500	-	-	500	Pass
	Top Rail Adjacent to Connection Concentrated Load	200	500	-	-	500	Pass
	Horizontal Uniform Load (per ft)	50	125	1010	503	1005	Pass

Direction	Test	Design Load (Inward/Outward) (kN)	Factored Load	Calculated Moment (kNm)	Equivalent Quarter-Point Load (kN)	Required Proof Load (kN)	Pass/Fail
Outward	Individual Elements (over 305 mm in. x 305 mm) (most critical location)	0.22	0.56	-	-	0.56	Pass
	Midspan Horizontal Concentrated Load	0.89	2.22	-	-	2.22	Pass
	Top Rail Adjacent to Connection Concentrated Load	0.89	2.22	-	-	2.22	Pass
	Horizontal Uniform Load (per m)	0.73	1.83	1.37	2.24	4.47	Pass

Test:	Loads on Guards	Project:	G104715588
Date:	23-Jul-21	Eng/Tech:	Kevin Penner
Client:	Cendek Railings Ltd.		Baldeep Sandhu
Product:	8 ft. Century Round Welded Panel - WB Mount (3.5 in. Picket Spacing)	Reviewer:	Coquitlam, BC, Canada
Post Spacing:	8.04 ft		2.45 m
Height of Guard:	42.1 in		1070 mm
Opening in Guard:	3.50 in		89 mm (between pickets)
	2.25 in		57 mm (under bottom rail)
Method:	ASTM E935-13e1, <i>Standard Test Methods for Performance of Permanent Metal Railing Systems and Rails for Buildings</i> 2018 International Building Code (IBC) 2018 International Residential Code (IRC)		
Safety Factor:	2.50		
Equipment:	Artech 5000 lbf Load Cell (Intertek ID# P60692, cal due October 22, 2021)		
	T&D TR-72Ui Temperature and Humidity Logger (Intertek ID# P60554, cal due September 10, 2021)		
	Stopwatch (Intertek ID# P60444, cal due March 5, 2022)		
	Mitutoyo Digital Caliper (Intertek ID# 52650, cal due June 8, 2022)		
Time/Temp/RH:	1:15PM / 22.8°C / 48.0%		

Direction	Test	Design Load (Inward/Outward) (lbf)	Factored Load	Calculated Moment (lbf-ft)	Equivalent Quarter-Point Load (lbf)	Required Proof Load (lbf)	Pass/Fail
Outward	Individual Elements (over 12 in. x 12 in.) (most critical location)	50	125	-	-	125	Pass
	Midspan Horizontal Concentrated Load	200	500	-	-	500	Pass
	Top Rail Adjacent to Connection Concentrated Load	200	500	-	-	500	Pass
	Horizontal Uniform Load (per ft)	50	125	1010	503	1005	Pass

Direction	Test	Design Load (Inward/Outward) (kN)	Factored Load	Calculated Moment (kNm)	Equivalent Quarter-Point Load (kN)	Required Proof Load (kN)	Pass/Fail
Outward	Individual Elements (over 305 mm in. x 305 mm) (most critical location)	0.22	0.56	-	-	0.56	Pass
	Midspan Horizontal Concentrated Load	0.89	2.22	-	-	2.22	Pass
	Top Rail Adjacent to Connection Concentrated Load	0.89	2.22	-	-	2.22	Pass
	Horizontal Uniform Load (per m)	0.73	1.83	1.37	2.24	4.47	Pass



Total Quality. Assured.

1500 Brigantine Drive
Coquitlam, BC, V3K 7C1

Telephone: 604-520-3321
Facsimile: 604-524-9186
www.intertek.com

TEST REPORT FOR CENDEK RAILINGS LTD.

Report No.: 104715588COQ-002D

Date: 08/16/21

APPENDIX B – PHOTOS (2 PAGES)

TEST REPORT FOR CENDEK RAILINGS LTD.

Report No.: 104715588COQ-002D

Date: 08/16/21



Figure 1. In-fill Load Test



Figure 2. Horizontal Uniform Load Test

TEST REPORT FOR CENDEK RAILINGS LTD.

Report No.: 104715588COQ-002D

Date: 08/16/21

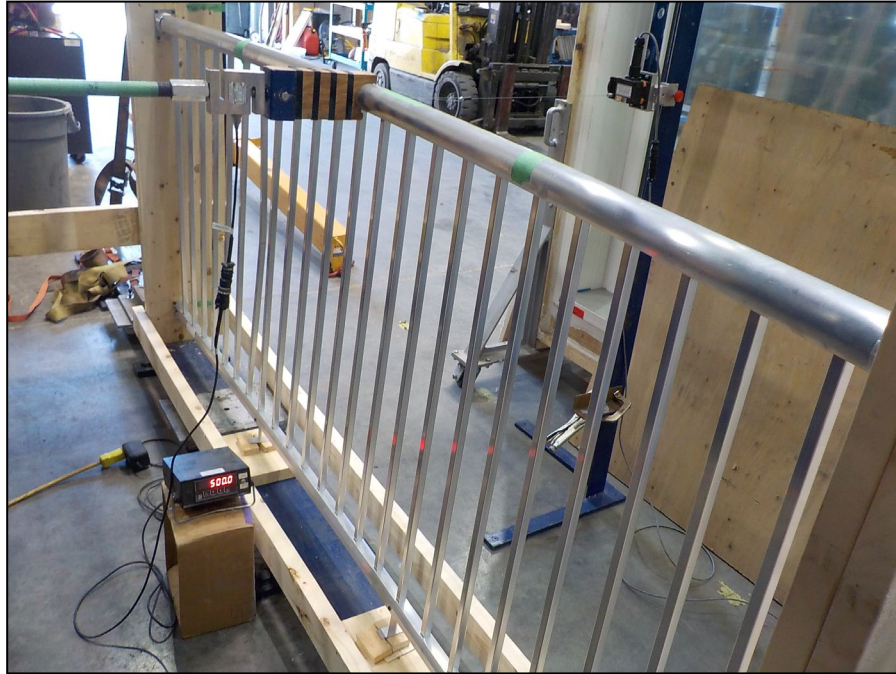


Figure 3. Horizontal – Mid-Span of Top Rail Concentrated Load



Figure 4. Horizontal – Top Rail Adjacent to Post Connection Concentrated Load



Total Quality. Assured.

1500 Brigantine Drive
Coquitlam, BC, V3K 7C1

Telephone: 604-520-3321
Facsimile: 604-524-9186
www.intertek.com

TEST REPORT FOR CENDEK RAILINGS LTD.

Report No.: 104715588COQ-002D




Date: 08/16/21

APPENDIX C – CENTURY ROUND WELDED PANEL DRAWINGS (8 PAGES)

intertek
 Test sample complies with these details.
 Deviations are noted.

Report #: 10471558800-002A
 Date: 08/16/21 Tech: C382
 100-49mm

ITEM NO.	Eng No.	Part No.	DESCRIPTION	QTY.
1	2594A	NA	Century Welded 8' 5/8" Panel	1
2	0032AA	4104-WAL-10100	Top Wall Bracket Round	2
3	0033A	4100-WAL-10100	Bottom Wall Bracket	2
4	0060PA	4600-LEG-60100	Surface Support Leg - SL	2
5	0096PA	9000-SLB-20001	Screw # 10x3/4" P/H Soc Tek Zinc	12

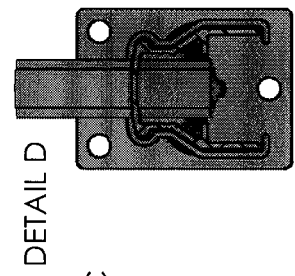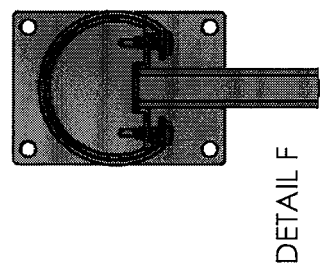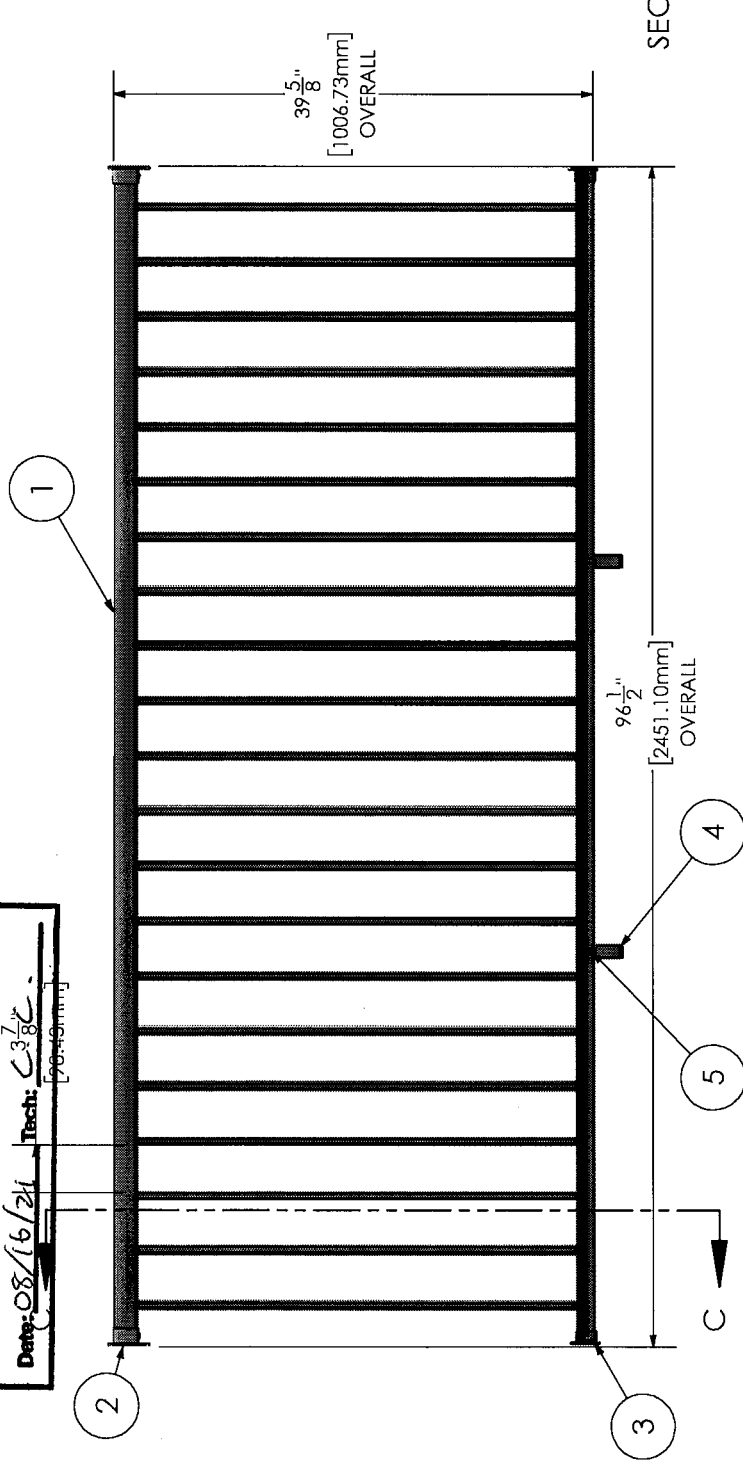

SECTION C-C

DESCRIPTION	
Century Round 8' 5/8" Welded Panel WB System	Part No. NA
Weight 17.05 lbs	Eng No. 2590A
	SHEET 1 OF 1
	Rev -

CenDek Railings Ltd.



PROPRIETARY AND CONFIDENTIAL
 THE INFORMATION CONTAINED IN THIS DRAWING IS THE SOLE PROPERTY OF CENDEK RAILINGS LTD. ANY REPRODUCTION IN PART OR AS A WHOLE WITHOUT THE WRITTEN PERMISSION OF CENDEK RAILINGS LTD IS PROHIBITED.

DRAWN BY	Engl
CREATED	2021-07-19
MATERIAL	
DIE NO.	


ALL DIMENSION IN INCHES/MM

intertek
 Test sample complies with these details.
 Deviations are noted.
 Report #: 104715588602-0020
 Date: 08/16/21 Tech: C.C.

ITEM NO.	Eng No.	Part No.	DESCRIPTION	QTY.
1	2590A	NA	5/8" Picket Panel 42" Round 8' - 3.5in Spacing	1
2	0033A	4100-WAL-10100	Bottom Wall Bracket	2
3	0032AA	4104-WAL-10100	Top Wall Bracket Round	2
4	0060PA	4600-LEG-60100	Surface Support Leg - SL	2
5	0096PB	9000-SLB-21001	Screw #10x3/4" P/H Soc Tek Stainless	12

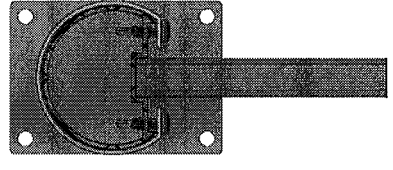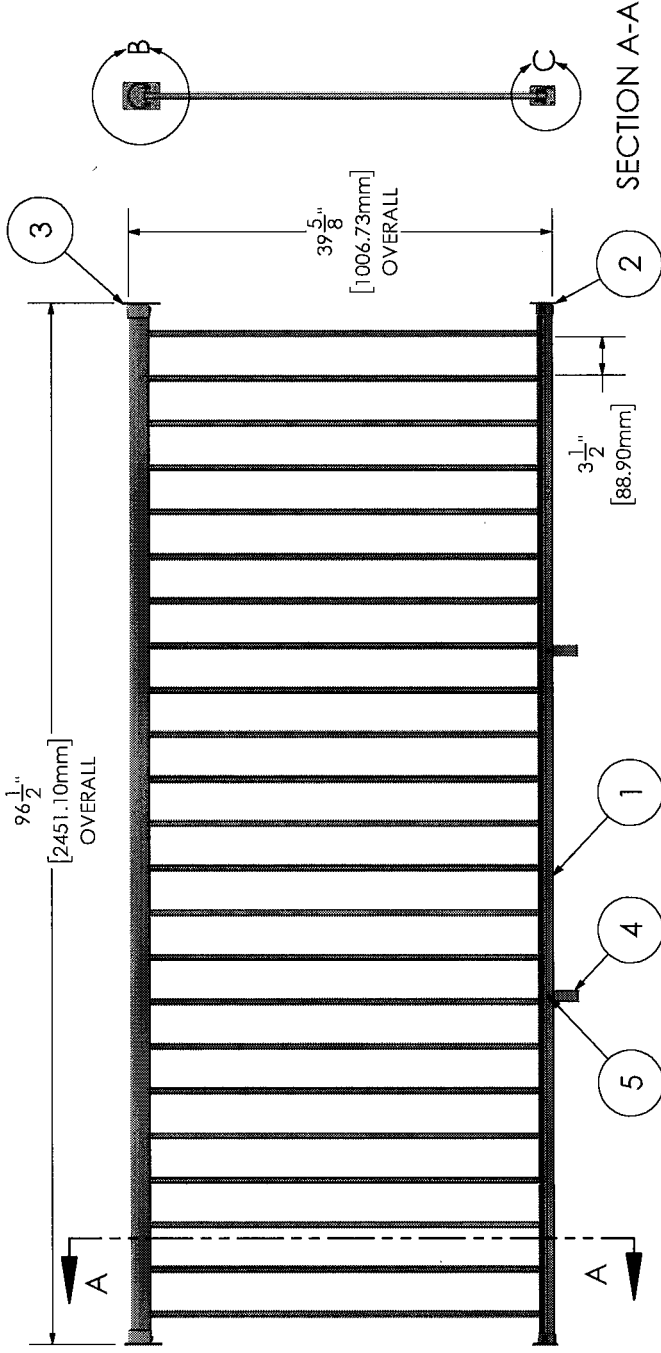

DETAIL B

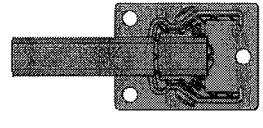

DETAIL C

SECTION A-A




Cendek Railings Ltd.
 PROPRIETARY AND CONFIDENTIAL
 THE INFORMATION CONTAINED IN THIS DRAWING IS THE SOLE PROPERTY OF CENDEK RAILINGS LTD. ANY REPRODUCTION IN PART OR AS A WHOLE WITHOUT THE WRITTEN PERMISSION OF CENDEK RAILINGS LTD IS PROHIBITED.

DRAWN BY	Eng1
CREATED	2021-08-04
MATERIAL	
DIE NO.	
ALL DIMENSION IN INCHES/MM	

DESCRIPTION	Century Welded Panel 8ft 5/8in Picket - 3.5in Picket Spacing
Part No. NA	Eng No. 2595A
Weight 17.84 lbs	SHEET 1 OF 1
	Rev -

4 3 2 1

ITEM NO.	Eng No.	Part No.	DESCRIPTION	QTY.
1	0014PE	1700-FLA-16007	Flat Bar Cut 1/8" x 2-1/2" x 3-1/2" Uni/Rnd WB, 90° WB x4	1
2	0012PA	1604-SLE-20025	Top Rail Sleeve Round cut WB, Post Sleeve	1

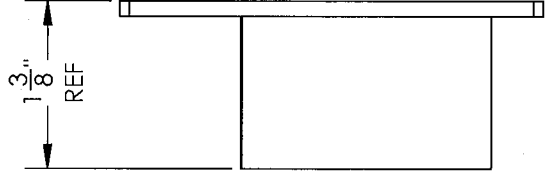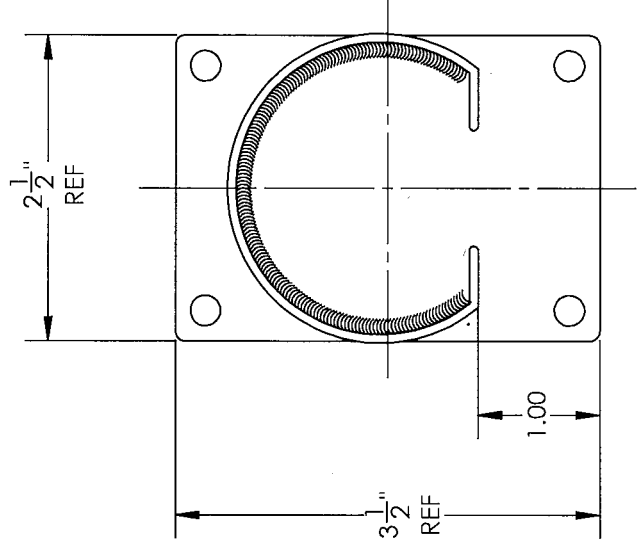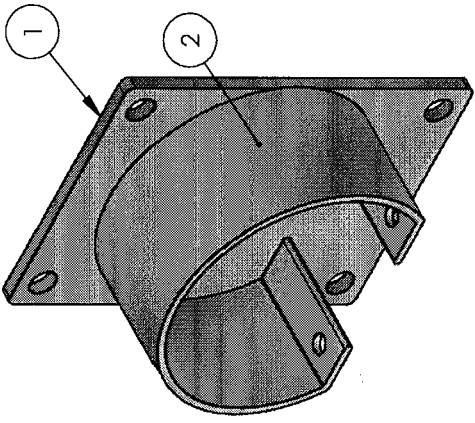

intertek

Test sample complies with these details.
Deviations are noted.

Report #: 104715588 C0Q-002A

Date: 08/16/21 Tech: C.C.

<p>PROPRIETARY AND CONFIDENTIAL THE INFORMATION CONTAINED IN THIS DRAWING IS THE SOLE PROPERTY OF CENDEK RAILINGS LTD. ANY REPRODUCTION IN PART OR AS A WHOLE WITHOUT THE WRITTEN PERMISSION OF CENDEK RAILINGS LTD IS PROHIBITED.</p>	DRAWN BY	cchislett	2/19/2021	DESCRIPTION Top Wall Bracket Round
	CHECKED			
	MATERIAL	Material <not specified>		
	DIE NO.			
ALL DIMENSION IN INCHES/MM				Part No. 4104-WAL-10100 Eng No. 0032AA Weight 0.16 lbs SHEET 1 OF 2 Rev 1

D C B A

D C B A

3 2 1

4 3 2 1

1

2

3

4

intertek

Test sample complies with these details.
Deviations are noted.

Report #: 104715586COR-002A

Date: 08/16/21 Tech: C.C.

ITEM NO.	Eng No.	Part No.	DESCRIPTION	QTY.
1	0014PH	1700-FLA-13002	Flat Bar Cut 1/8" x 1-3/4" x 2-3/8" BR WB, BR 90° WB x3	1
2	0051PA	1600-SLE-10011	Bottom Rail Sleeve Welded Cut WB	1

D

D

C




C

B

B

A

A

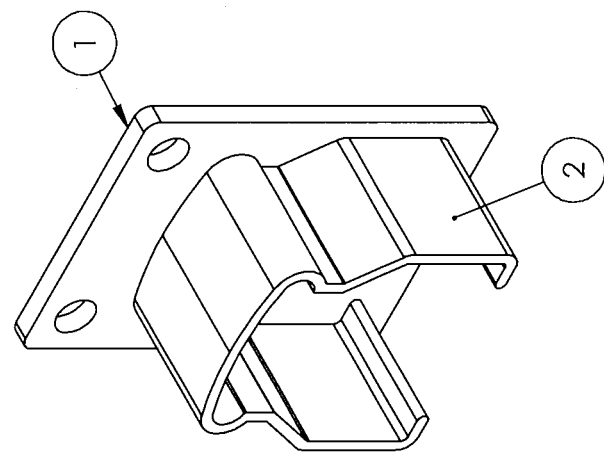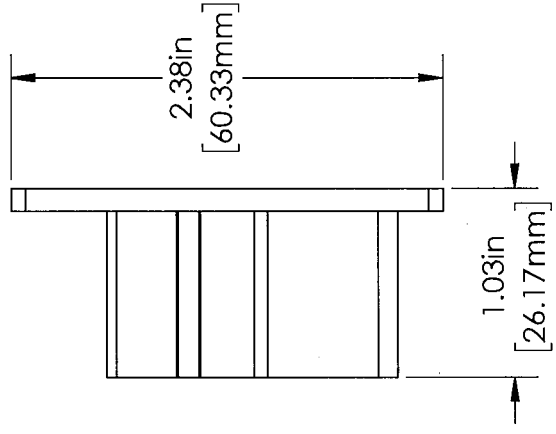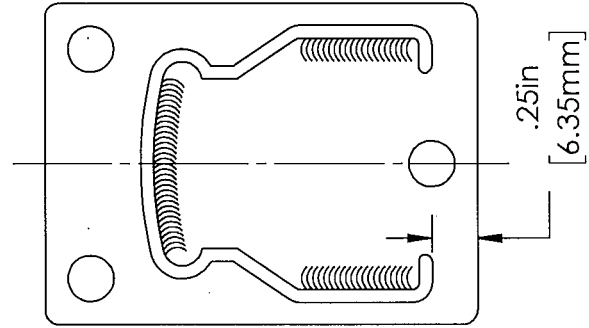

PROPRIETARY AND CONFIDENTIAL
THE INFORMATION CONTAINED IN THIS
DRAWING IS THE SOLE PROPERTY OF
CENDEK RAILINGS LTD. ANY REPRODUCTION IN PART
OR AS A WHOLE WITHOUT THE WRITTEN PERMISSION
OF CENDEK RAILINGS LTD IS PROHIBITED.

DRAWN BY	Admin
CREATED	10/3/2017
MATERIAL	Material <not specified>
DIE NO.	
ALL DIMENSION IN INCHES/MM	

DESCRIPTION
Bottom Wall Bracket

Part No. 4100-WAL-10100	Eng No. 0033A
Weight 0.08 lbs	SHEET 1 OF 2
	Rev -

REV.	DESCRIPTION	DATE	INITIALS


1

2

3

4

intertek
 Test sample complies with these details.
 Deviations are noted.
 Report #: 104715588 COQ 002D
 Date: 08/16/21 Tech: C.L.

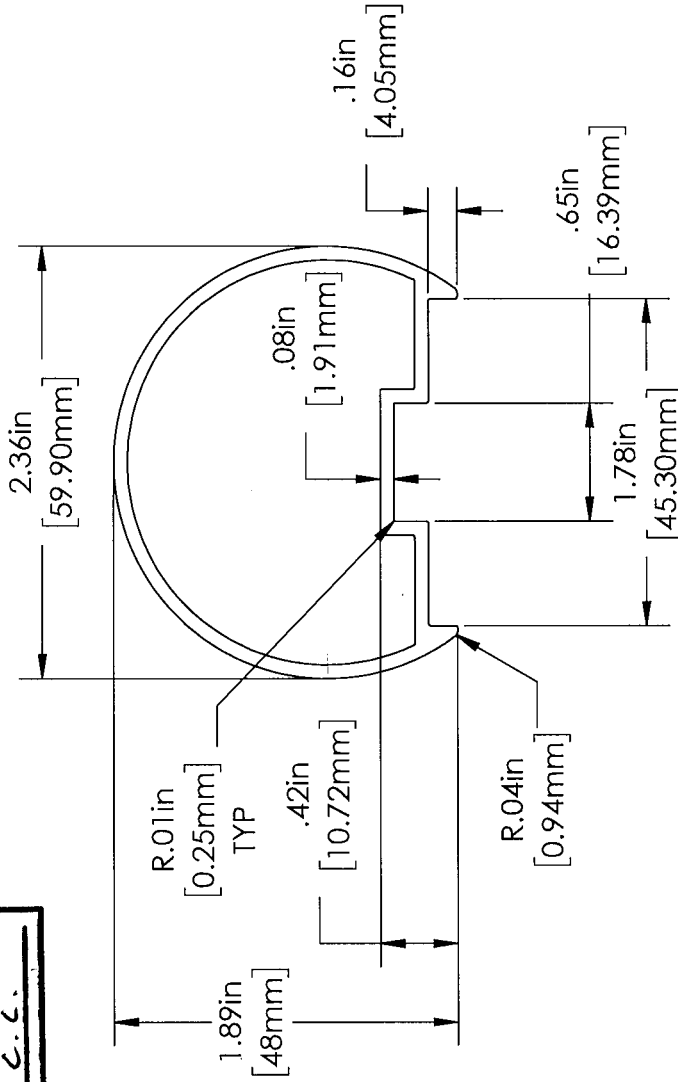

PROPRIETARY AND CONFIDENTIAL
 THE INFORMATION CONTAINED IN THIS
 DRAWING IS THE SOLE PROPERTY OF
 CENDEK RAILINGS LTD. ANY REPRODUCTION IN PART
 OR AS A WHOLE WITHOUT THE WRITTEN PERMISSION
 OF CENDEK RAILINGS LTD IS PROHIBITED.

DRAWN BY	Admin
CREATED	2017-08-11
MATERIAL	6063-T5
DIE NO.	
ALL DIMENSION IN INCHES/MM	

DESCRIPTION
 Century TR Weld

Part No.	Weight	0.22 lbs
Eng No.	0042P	
SHEET 1 OF 1		Rev

REVISIONS


REV.	DESCRIPTION	DATE	INITIALS

intertek

Test sample complies with these details.
Deviations are noted.

Report #: 104715588000-0020

Date: 08/16/21 Tech: C.C.

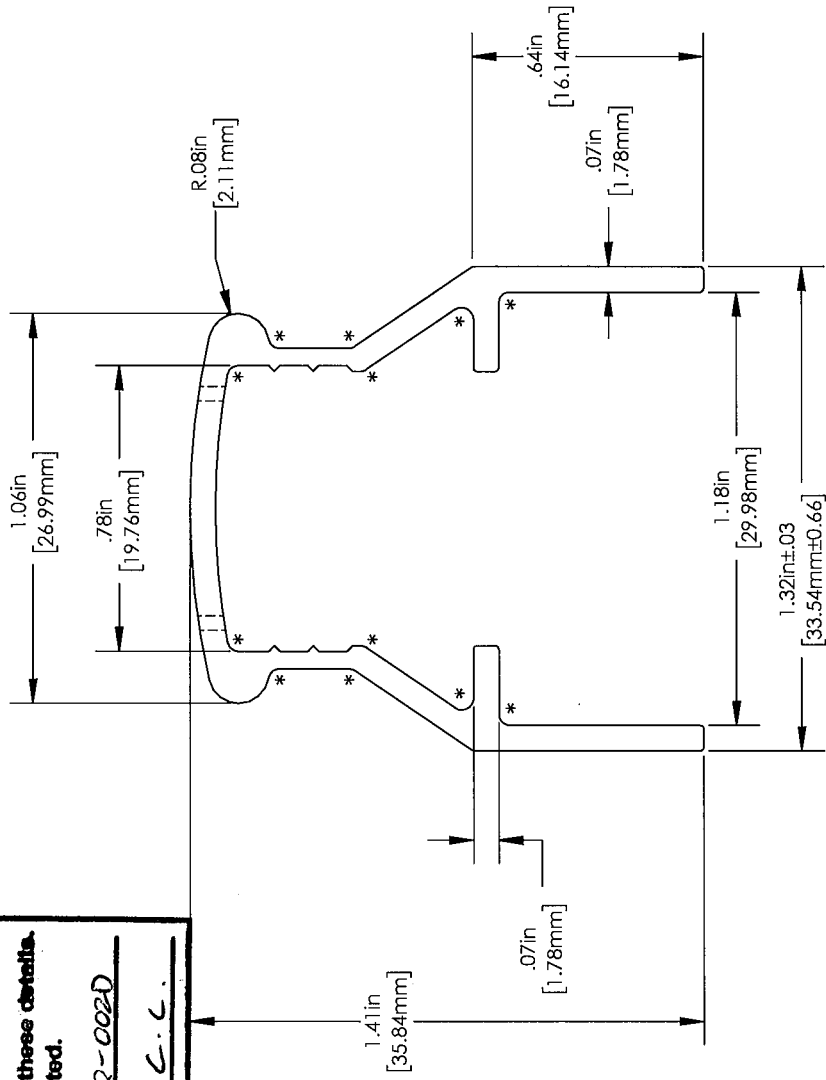

* R0.3in [0.80mm]



PROPRIETARY AND CONFIDENTIAL
THE INFORMATION CONTAINED IN THIS
DRAWING IS THE SOLE PROPERTY OF
CENDEK RAILINGS LTD. ANY REPRODUCTION IN PART
OR AS A WHOLE WITHOUT THE WRITTEN PERMISSION
OF CENDEK RAILINGS LTD IS PROHIBITED.

DESCRIPTION

5/8" Punched Welded Bottom Rail
20'6"

DRAWN BY cchislett 7/21/2021

CHECKED

MATERIAL 6063-T5 - CenDek

DIE NO.

ALL DIMENSION IN INCHES/MM

Part No. 1200-BOT-17246 Eng No. 0317PE


Weight 6.97 lbs/ft SHEET 1 OF 1 Rev

intertek

Test sample complies with these details.
Deviations are noted.




Report #: 104215588COR-002A

Date: 08/16/21 Tech: C.C.

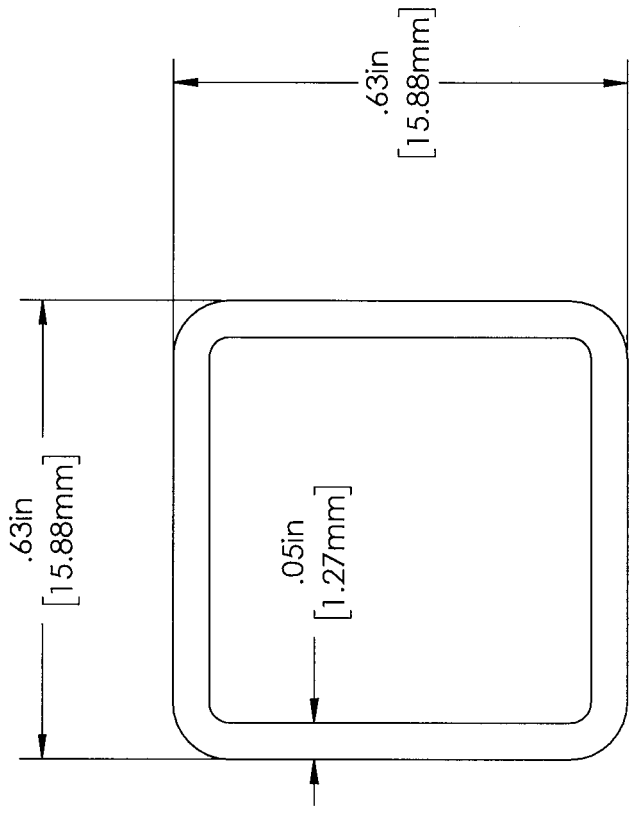

REV.	DESCRIPTION	DATE	INITIALS	REVISIONS
		07/21/2021	SB	
<p>PROPRIETARY AND CONFIDENTIAL THE INFORMATION CONTAINED IN THIS DRAWING IS THE SOLE PROPERTY OF CENDEK RAILINGS LTD. ANY REPRODUCTION IN PART OR AS A WHOLE WITHOUT THE WRITTEN PERMISSION OF CENDEK RAILINGS LTD IS PROHIBITED.</p>		DRAWN BY Admin CREATED 9/19/2017 MATERIAL 6063-T5 DIE NO.		DESCRIPTION 5/8" Picket
		ALL DIMENSION IN INCHES/MM		Part No. weight 0.41 lbs
				Eng. No. SHEET 1 OF 2 Rev -

4 3 2 1

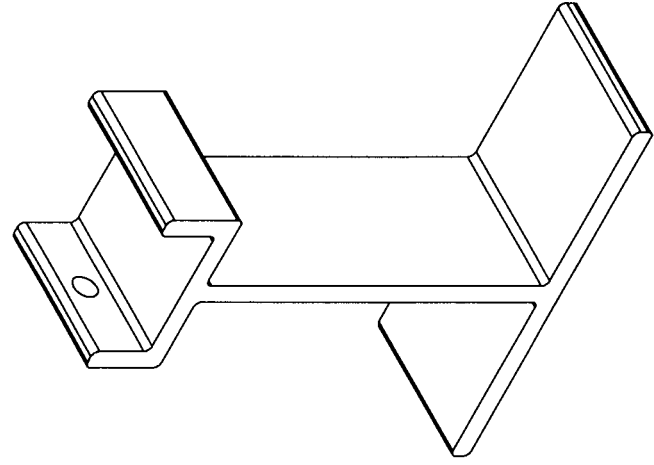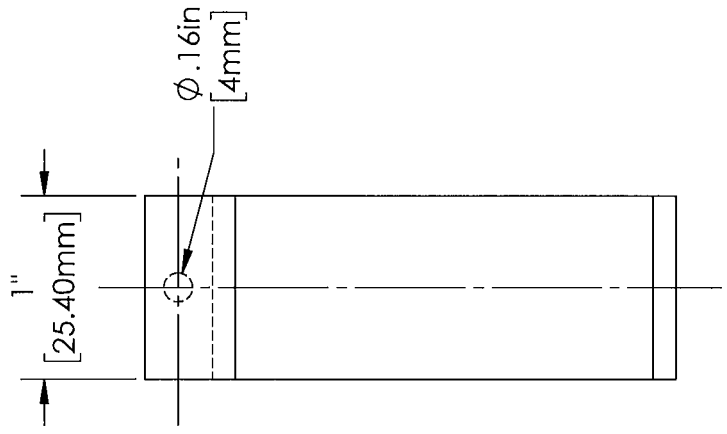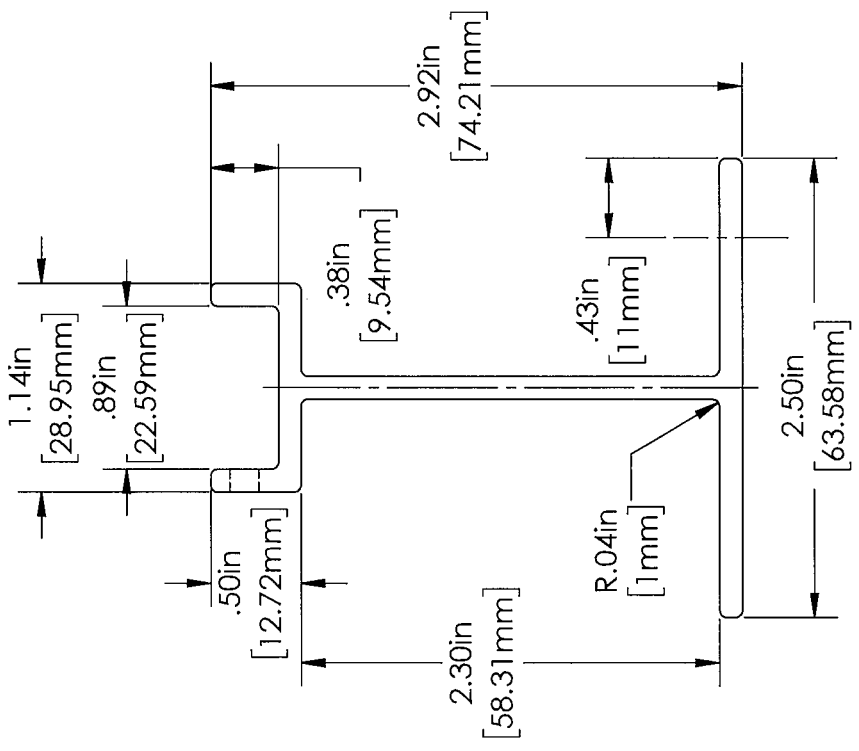

D C B A

intertek
 Test sample complies with these details.
 Deviations are noted.
 Report #: 10171558602-002D
 Date: 08/16/21 Tech: C-C

CenDek
 Railings Ltd.

PROPRIETARY AND CONFIDENTIAL
 THE INFORMATION CONTAINED IN THIS DRAWING IS THE SOLE PROPERTY OF CENDEK RAILINGS LTD. ANY REPRODUCTION IN PART OR AS A WHOLE WITHOUT THE WRITTEN PERMISSION OF CENDEK RAILINGS LTD IS PROHIBITED.

DRAWN BY	Admin
CREATED	10/2/2017
MATERIAL	6063-T5
DIE NO.	
ALL DIMENSION IN INCHES/MM	

DESCRIPTION
 Surface Support Leg - SL

Part No. 4600-LEG-60100	Eng. No. 0060PA
Weight 0.08 lbs	SHEET 2 OF 2
	Rev

4 3 2 1

TEST REPORT FOR CENDEK RAILINGS LTD.

Report No.: 104715588COQ-002D

Date: 08/16/21

SECTION 12

REVISION LOG

REVISION #	DATE	PAGES	REVISION
0	08/16/21	N/A	Original Report Issue